


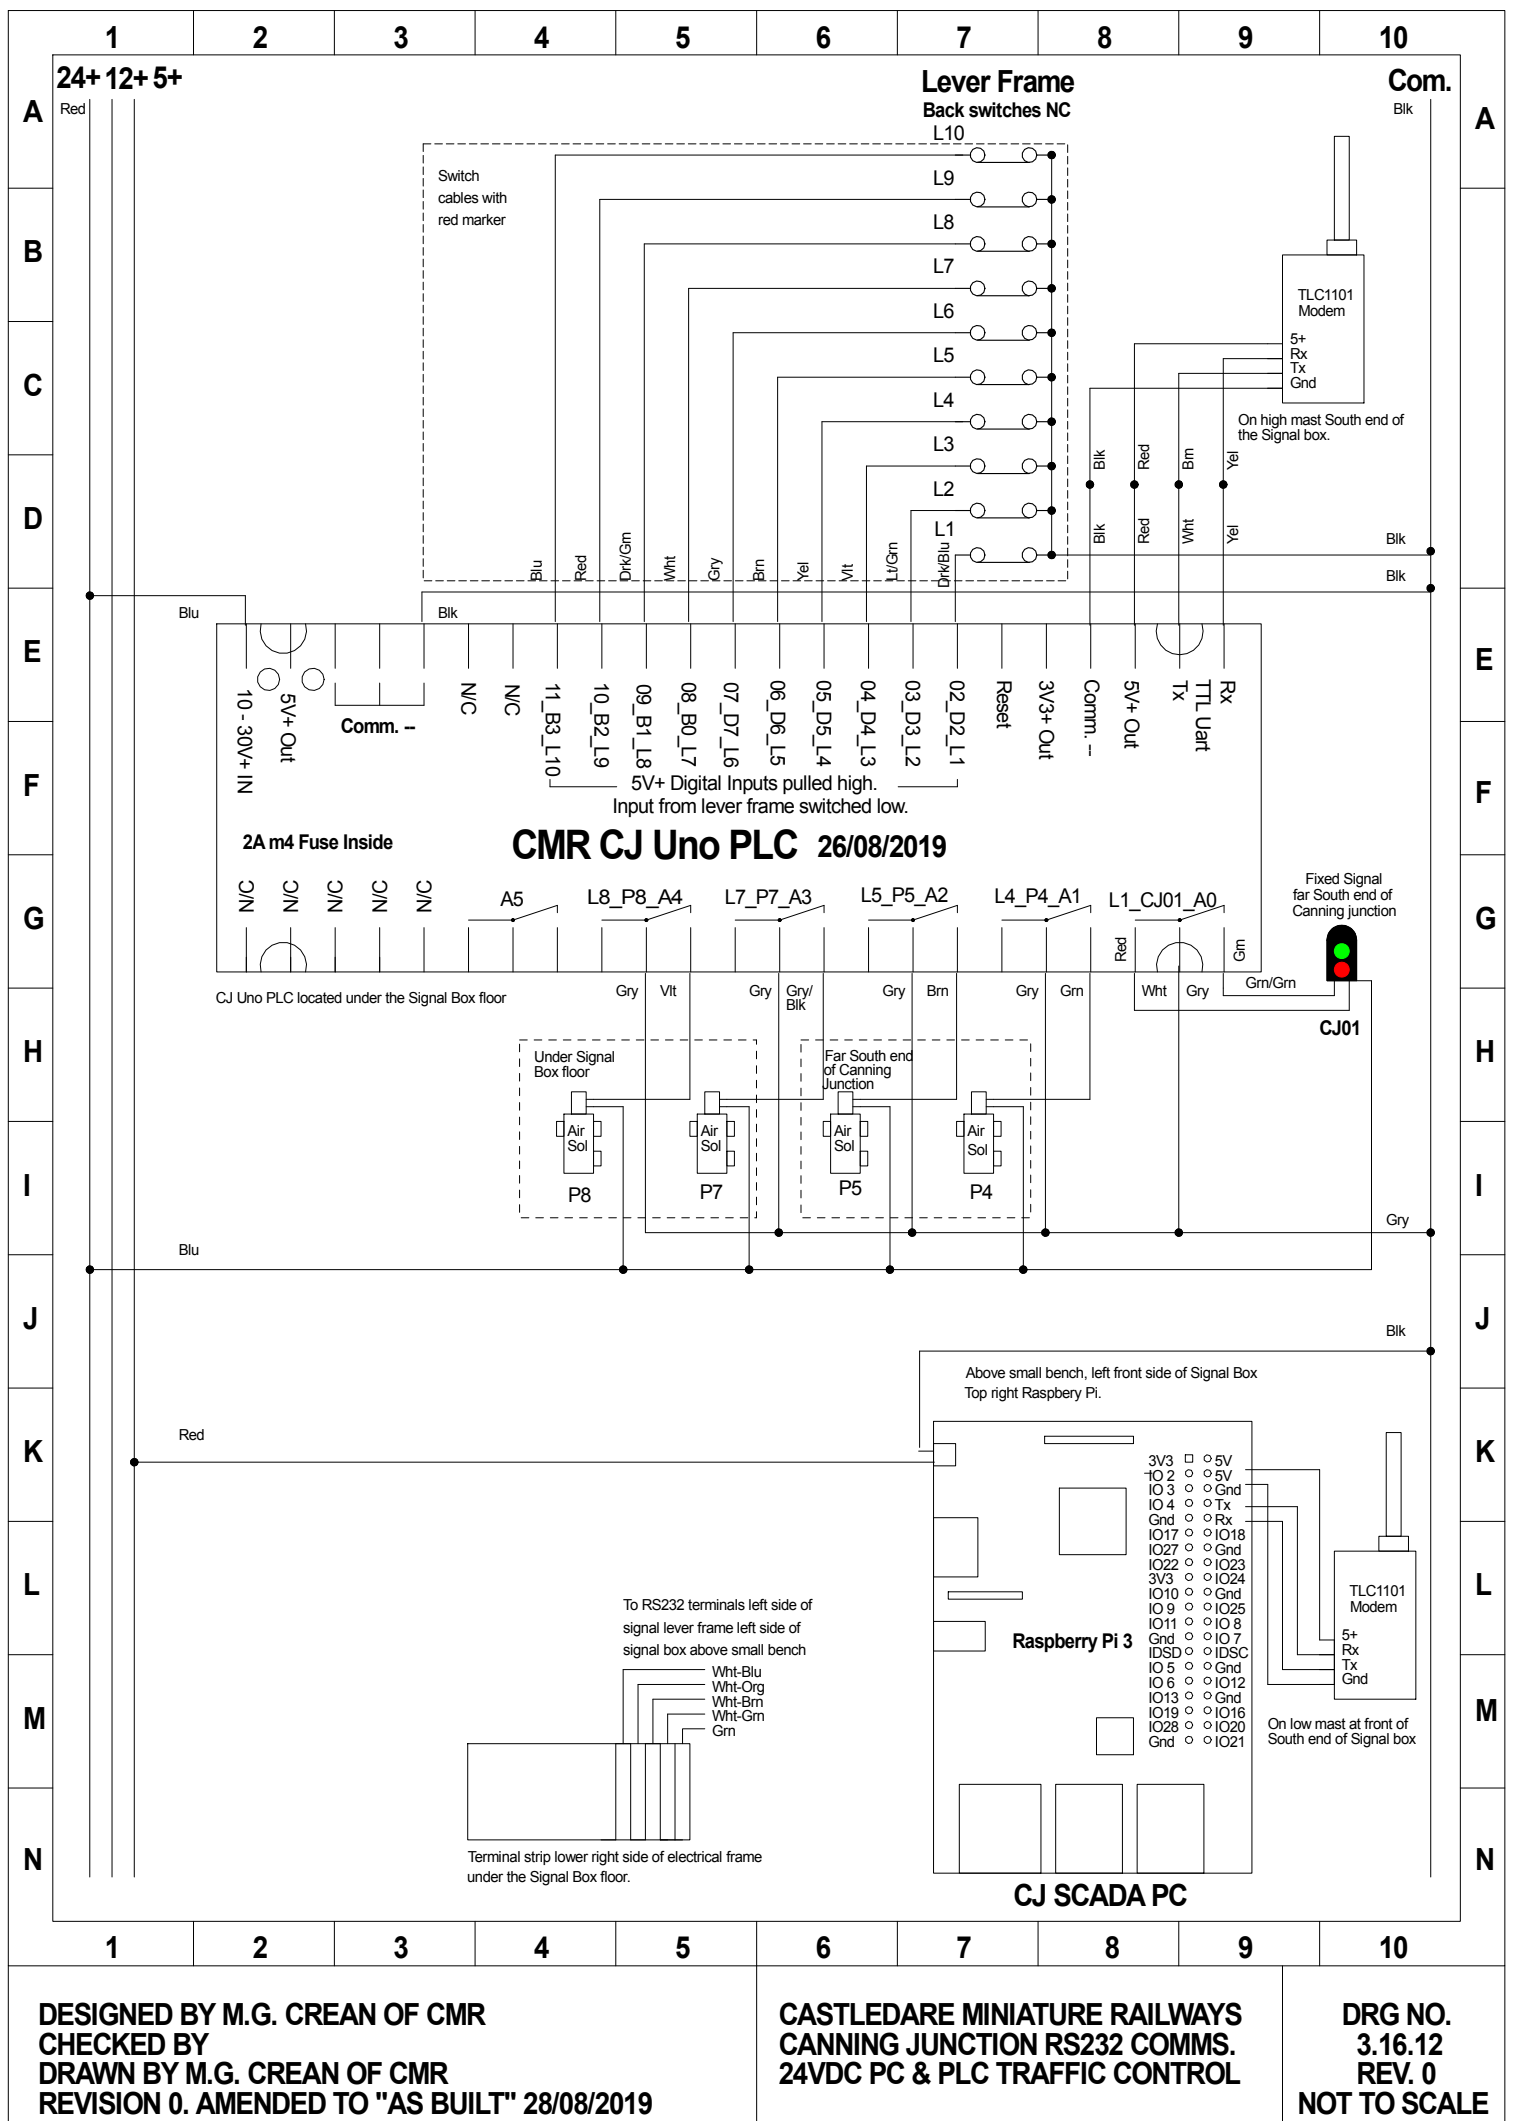

DESIGNED BY M.G. CREAM OF CMR
CHECKED BY
DRAWN BY M.G. CREAM OF CMR
REVISION 0. AMENDED TO "AS BUILT" 28/08/2019

CASTLEDARE MINIATURE RAILWAYS
CANNING JUNCTION RS232 COMMS.
24VDC PC & PLC TRAFFIC CONTROL

DRG NO.
3.16.12
REV. 0
NOT TO SCALE